




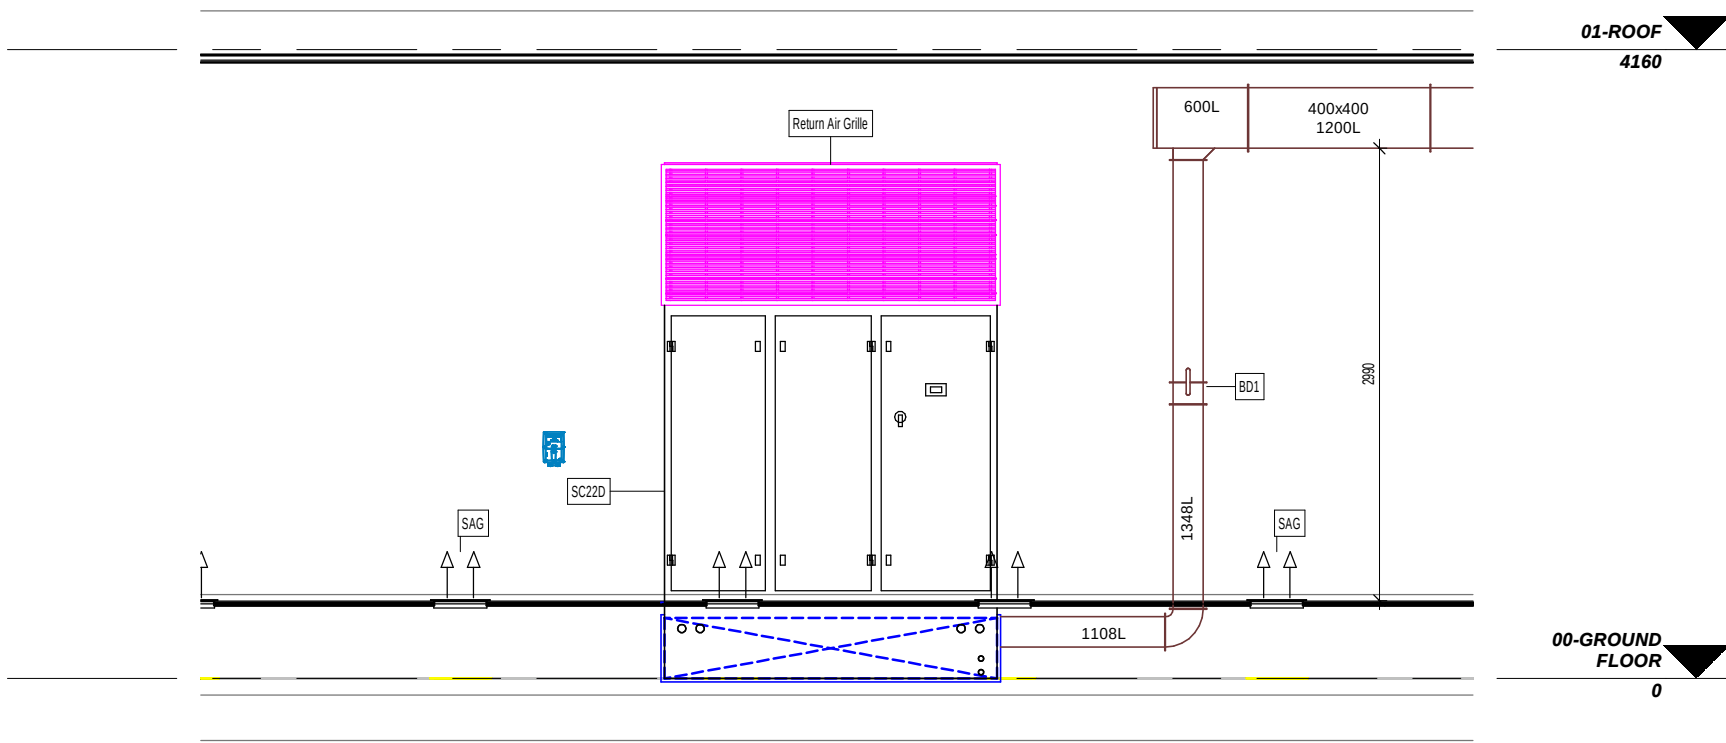


TYPICAL GAS EXTRACTION
1 : 50

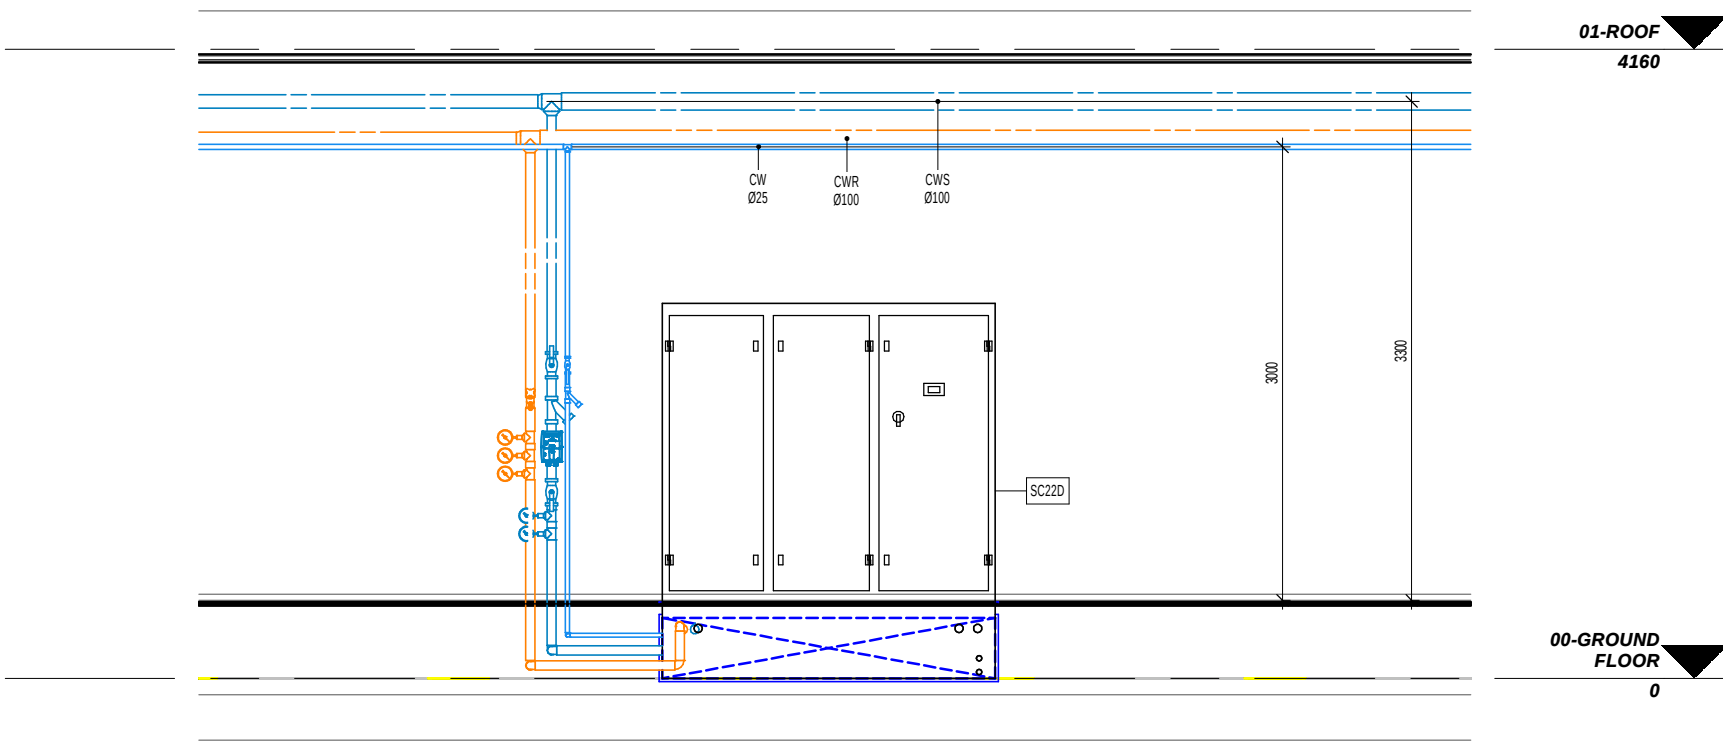


TYPICAL HUMIDIFICATION & CW PIPES CONNECTION TO AC UNITS
1 : 50

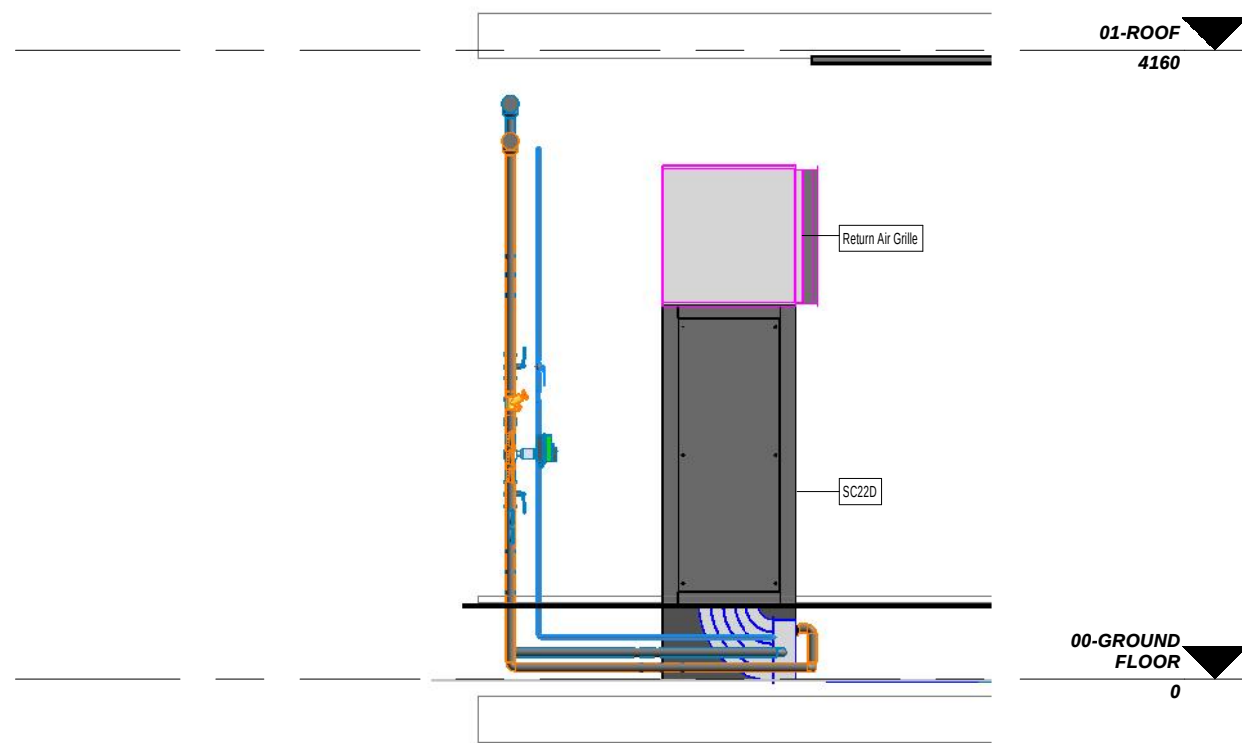

AC UNIT SIDE VIEW
1 : 50

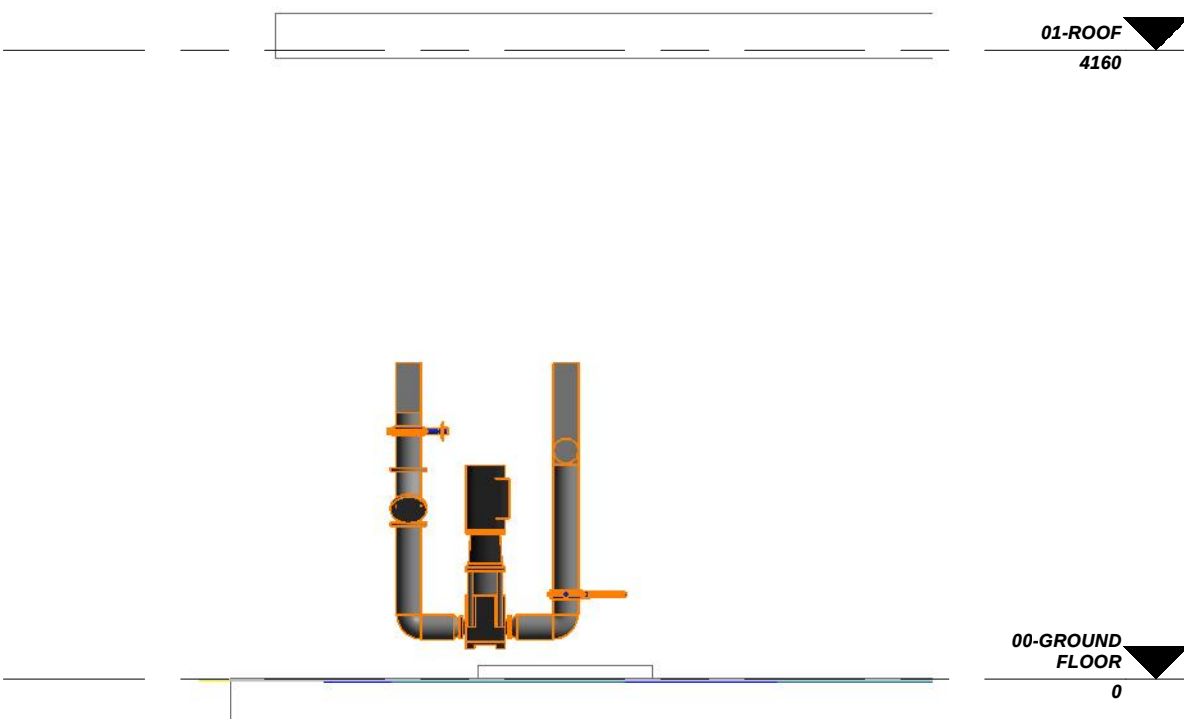

A-CONDENSER WATER PUMPS CONFIGURATION
1 : 50

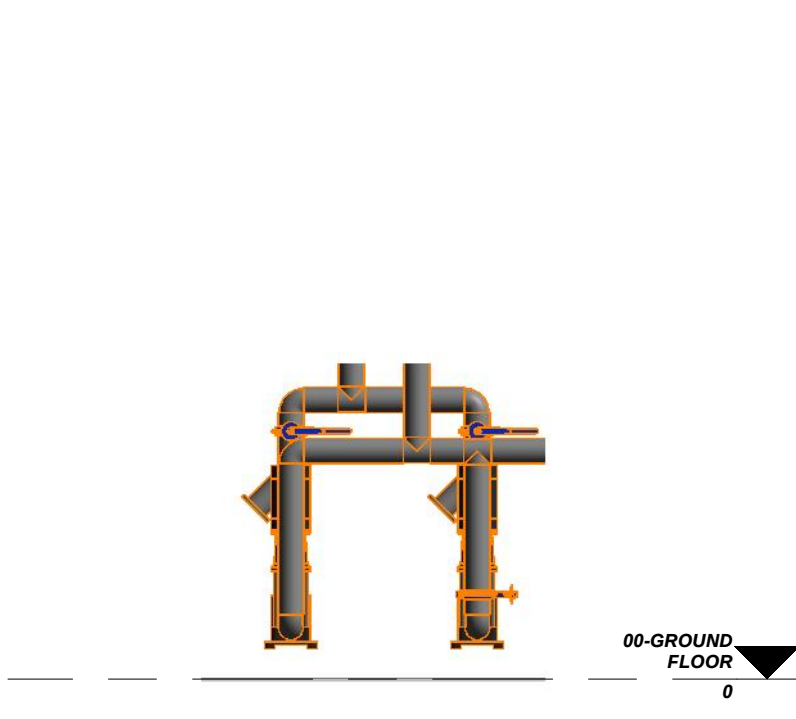

B-CONDENSER WATER PUMPS CONFIGURATION
1 : 50

NOTES:

- FOR GENERAL NOTES REFER TO DRAWING
- DRAWINGS ARE NOT TO BE SCALED. ALL LEVELS AND DIMENSIONS TO BE VERIFIED ON SITE PRIOR TO COMMENCEMENT OF WORKS. ANY DISCREPANCIES TO BE BROUGHT TO THE ENGINEERS ATTENTION IMMEDIATELY
- THIS DRAWING IS TO BE READ IN CONJUNCTION WITH ALL OTHER DRAWINGS, SCHEDULES AND SPECIFICATIONS RELATED TO THIS PROJECT.
- ALL BUILDING WORK AND MATERIALS ARE TO COMPLY WITH LOCAL AUTHORITY'S REQUIREMENTS AND ARE TO BE IN ACCORDANCE WITH SANS 10400 NATIONAL BUILDING REGULATIONS

NO	DATE	DESCRIPTION	DRN BY

CONSULTING ENGINEER SIGNATURE: _____
PROFESSIONAL REG: _____

DATE: _____

CLIENT SIGNATURE: _____

DATE: _____

CLIENT NAME:



CONSULTANTS DETAILS:

**Royal HaskoningDHV**
Enhancing Society Together

Fountain Square
75 Kalkoen Street
Mounment Park
Pretoria
Tel No. (087) 352-1500

HVAC CONTRACTORS DETAILS:

**Action**
REFRIGERATION
AIR CONDITIONING

27 Clough Street
Pietermaritzburg
KwaZulu Natal
+27 33 345 3135
admin@actionair.co.za

SERVICE:

MECHANICAL HVAC

PROJECT NAME:

SITA DATA & SWITCHING CENTRE

SHEET TITLE:

HVAC INSTALLATION TYPICAL DETAILS

DATE: 2021-04-05	ACTION REF NO: 0096
PAPER SIZE: A1	DESIGNED BY: ROYAL HASKONING DHV
SCALE: 1 : 50	DRAWN BY: P. M. CHAMBERS
	CHECKED BY: M. NUGENT

DRAWING NUMBER:

0096-MA-106

REV:

AS BUILT DRAWING